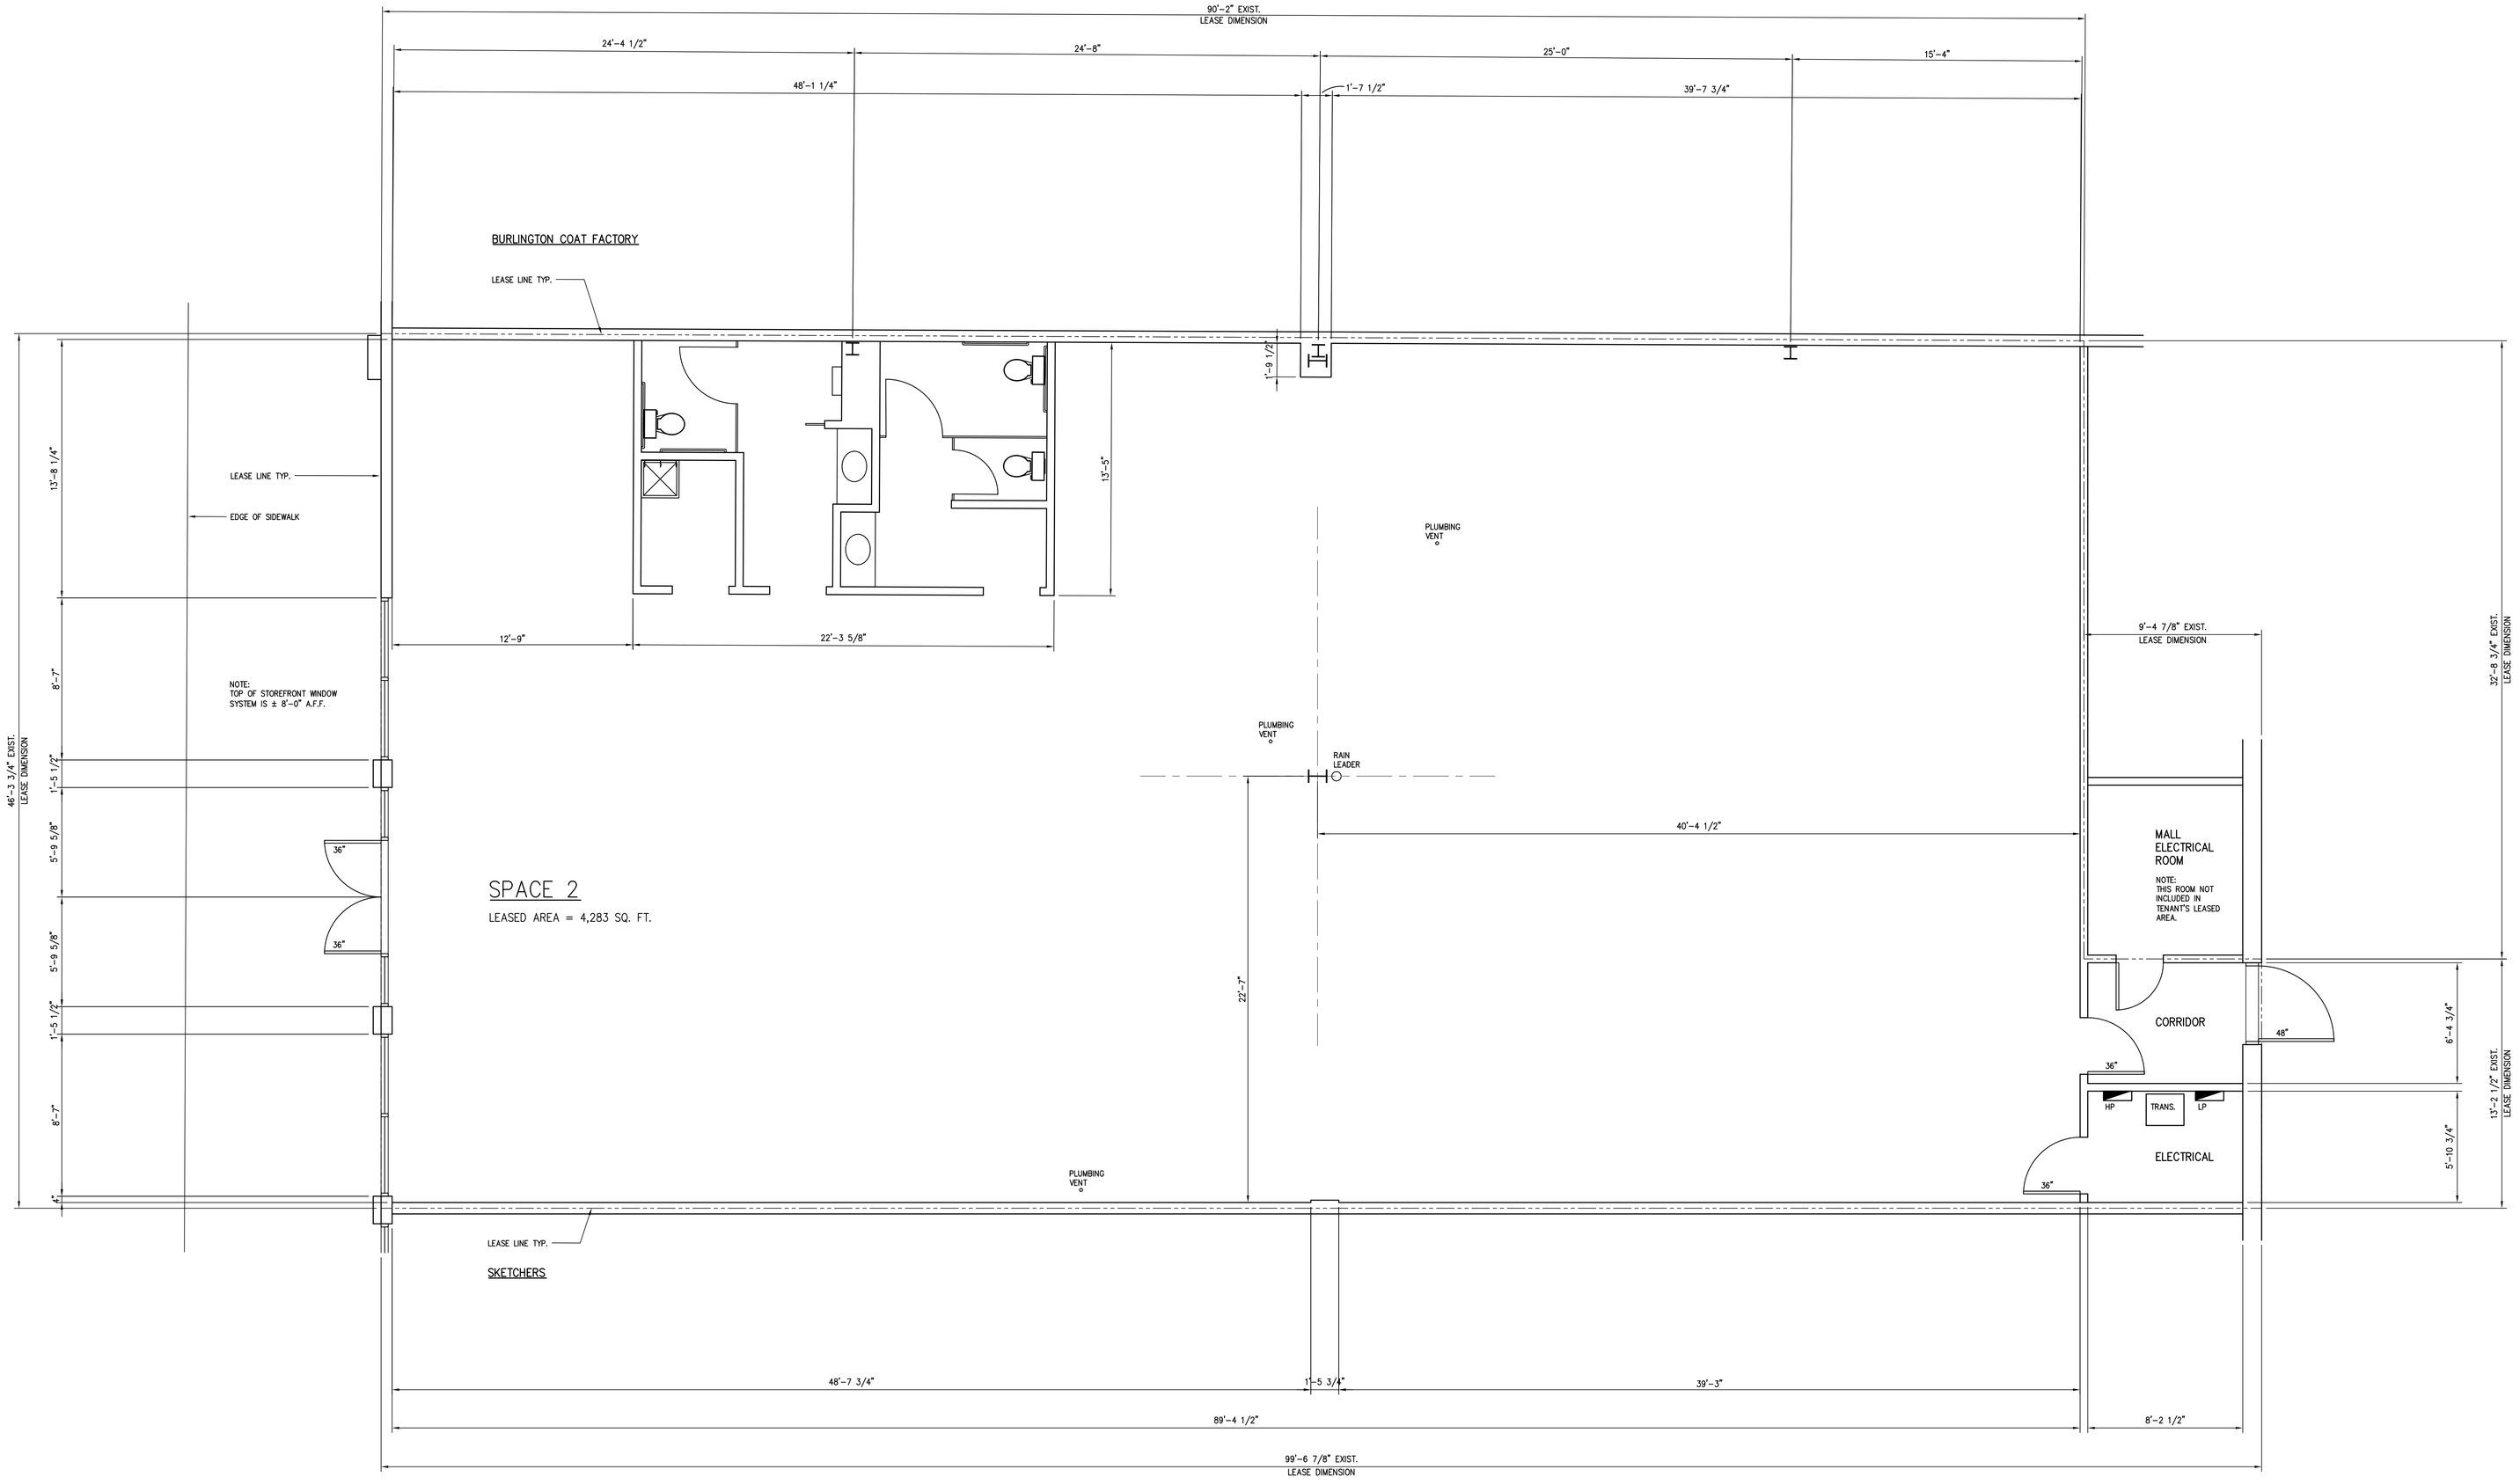

SPACE 2

LEASED AREA = 4,283 SQ. FT.

NOTE:
TENANT TO FIELD VERIFY ALL DIMENSIONS AND CONDITIONS.

NOTE:
ROOF DECK HEIGHT IS APPROXIMATELY 17'-6" TO 18'-1" A.F.F.

10/11/22

1 LOD **Lease Outline Plan**

0 1 2 4 8 FEET

D'ANGELO REAL ESTATE
BAYBERRY PLAZA
SPACE 2
150 HIGHLAND AVENUE
SEEKONK, MA 02771

GROUP 7 DESIGN
Architecture • Interiors • Construction Management
70 North Street, Suite 2B Medfield, MA 02052
Tel: (508) 458-4545

REGISTERED ARCHITECT
DAVID M. SORGMAN
No. 952834
CANTON, MA
COMMONWEALTH OF MASSACHUSETTS